




SUITE 1800

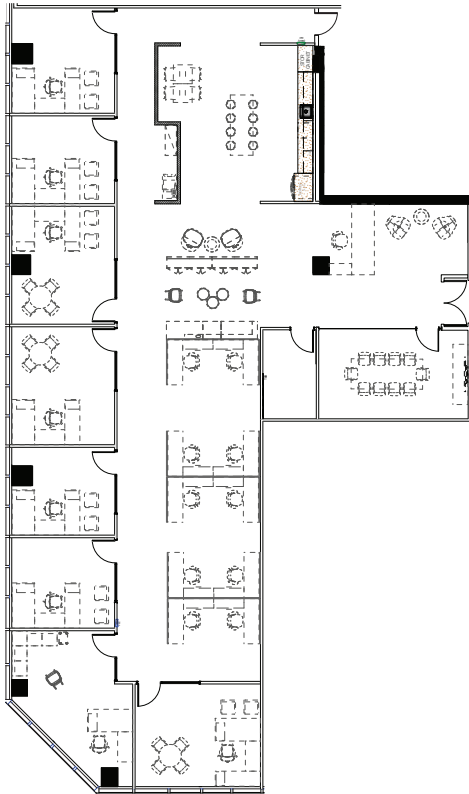

FUTURE SPEC LAYOUT

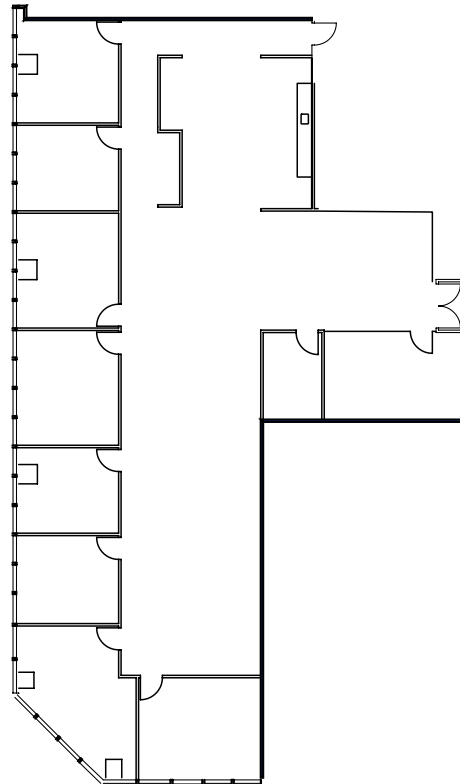

AS-BUILT

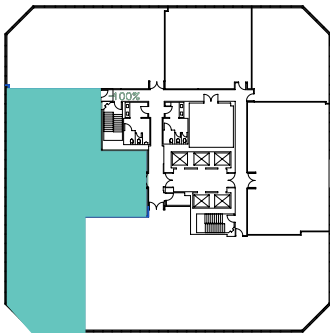

5,540
RSF

VACANT
Status

DESCRIPTION

Spec Suite with Modern Finishes, 8 Private
Offices, Bay Views